

millington lockwood, inc.

470 coyuga road  
buffalo, new york 14225-1310  
phone: (716) 633-5600  
fax: (716) 633-5641

project: STATE UNIV. OF NY AT BUFFALO  
NORTH CAMPUS  
KETTER HALL

title: Room 133A  
Furniture Plan

contact:

phone:

date: 15 NOV 2016

revisions:


notes:

drawn by: DLE


directory name:  
UB/KETTER/1STFL/DWGS/133A61908

scale: 1/4"=1'-0"


note:  
Property of Millington Lockwood, Inc.  
No part of this document may be  
reproduced or utilized in any form,  
without written authorization by  
Millington Lockwood, Inc.

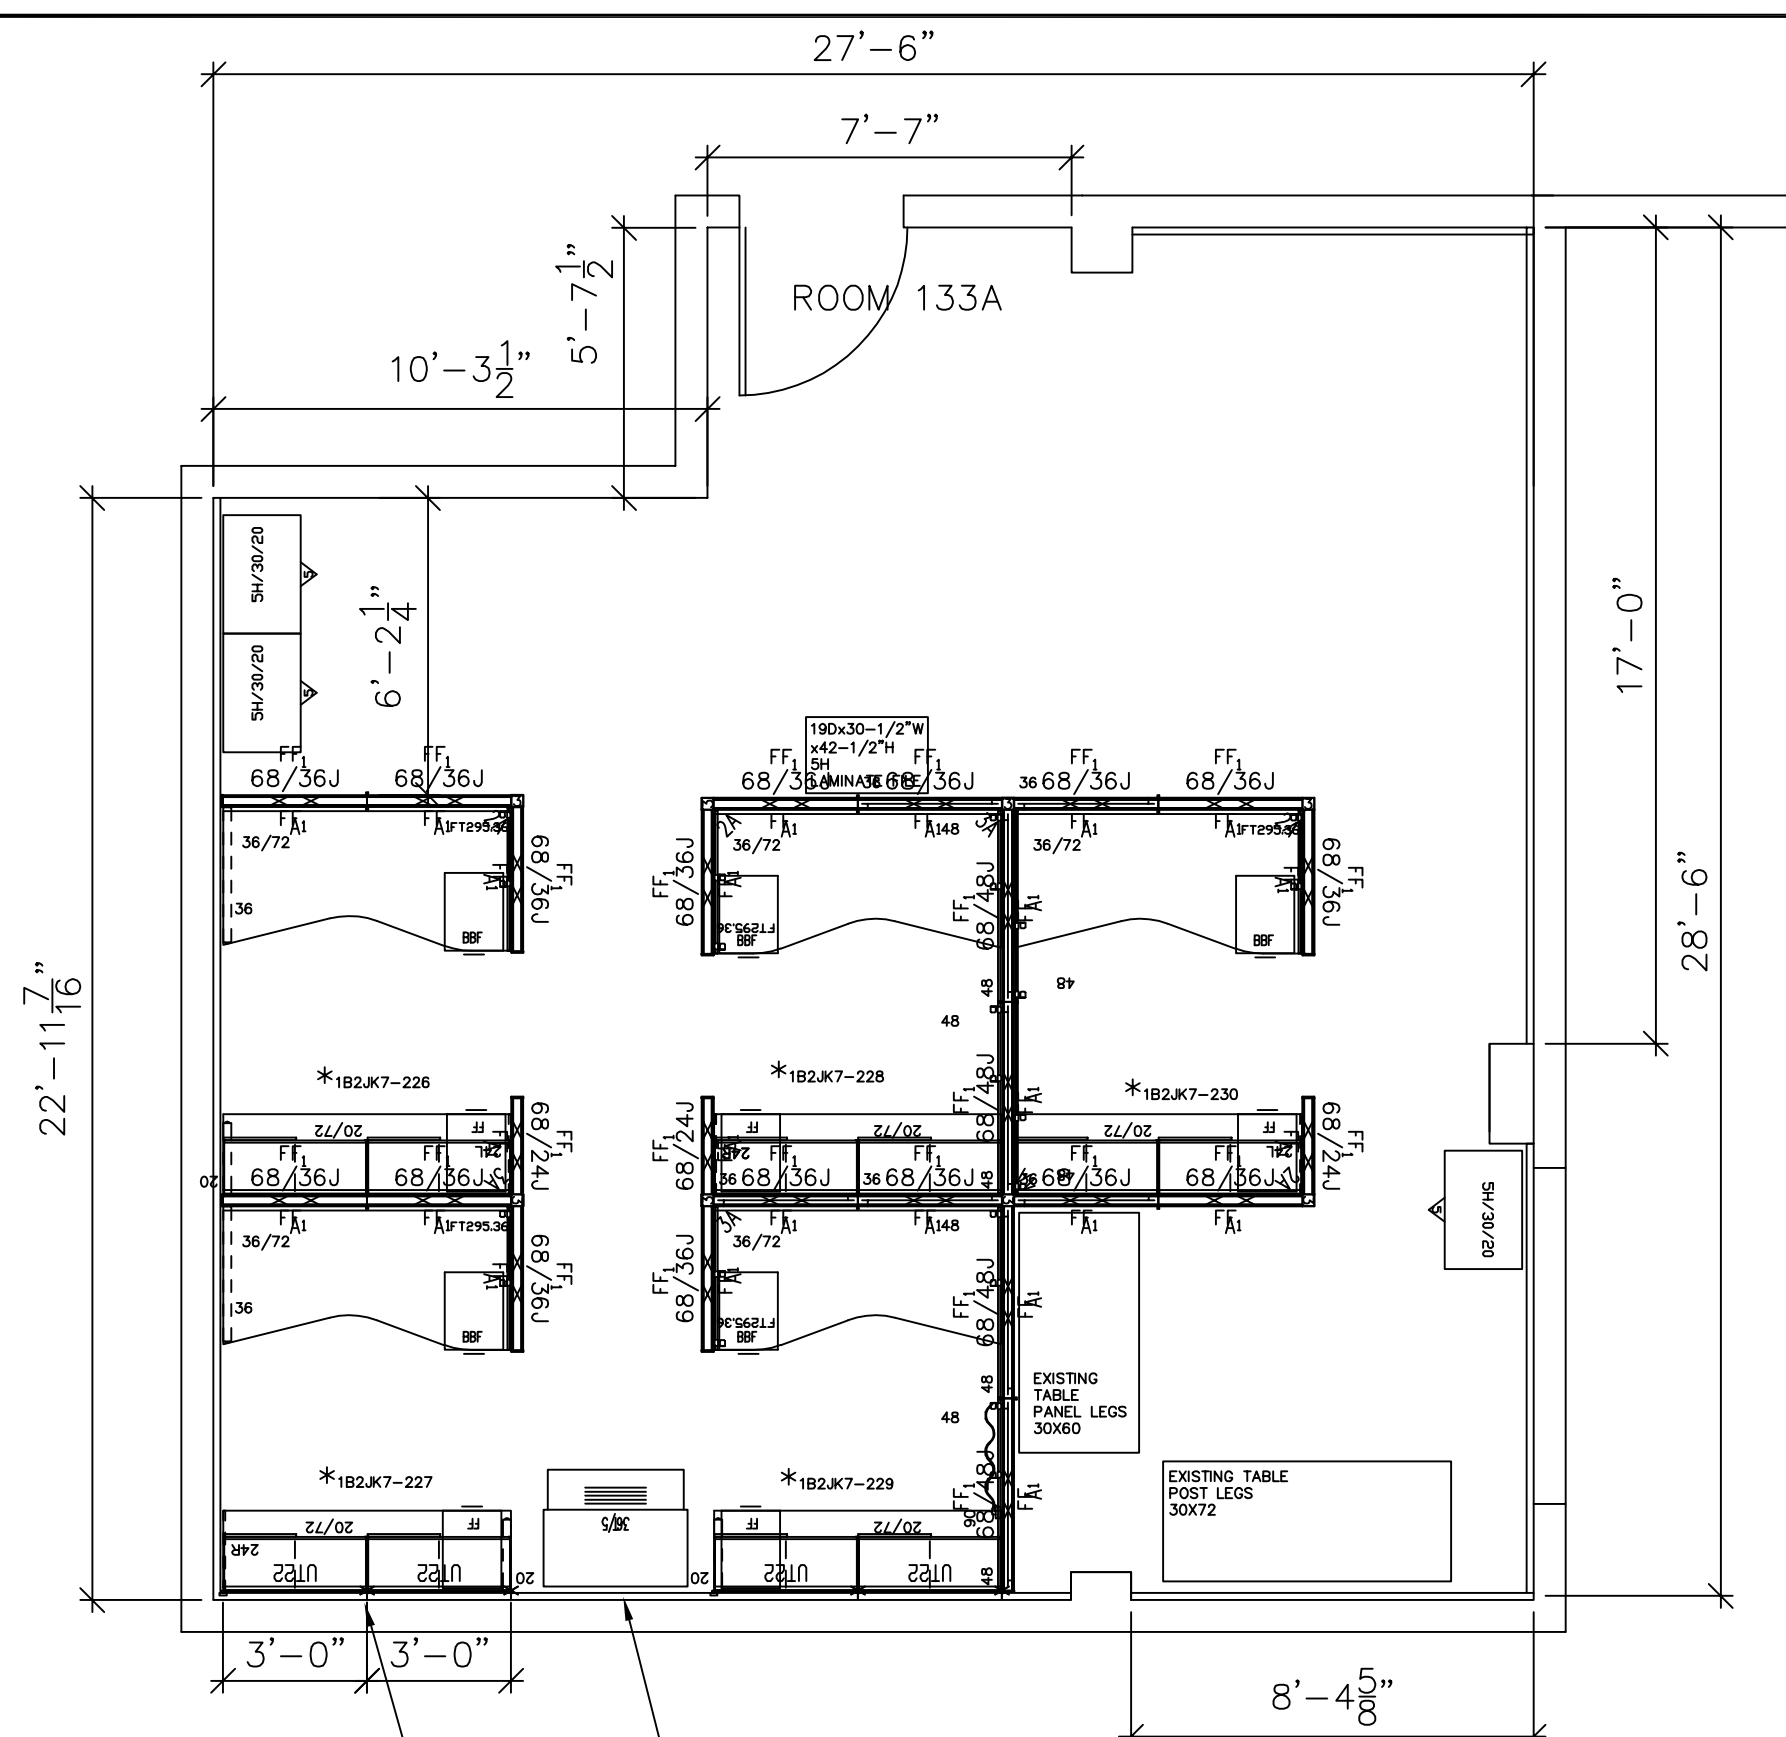

1 AS BUILT  
SCALE : 1/4"=1'-0"

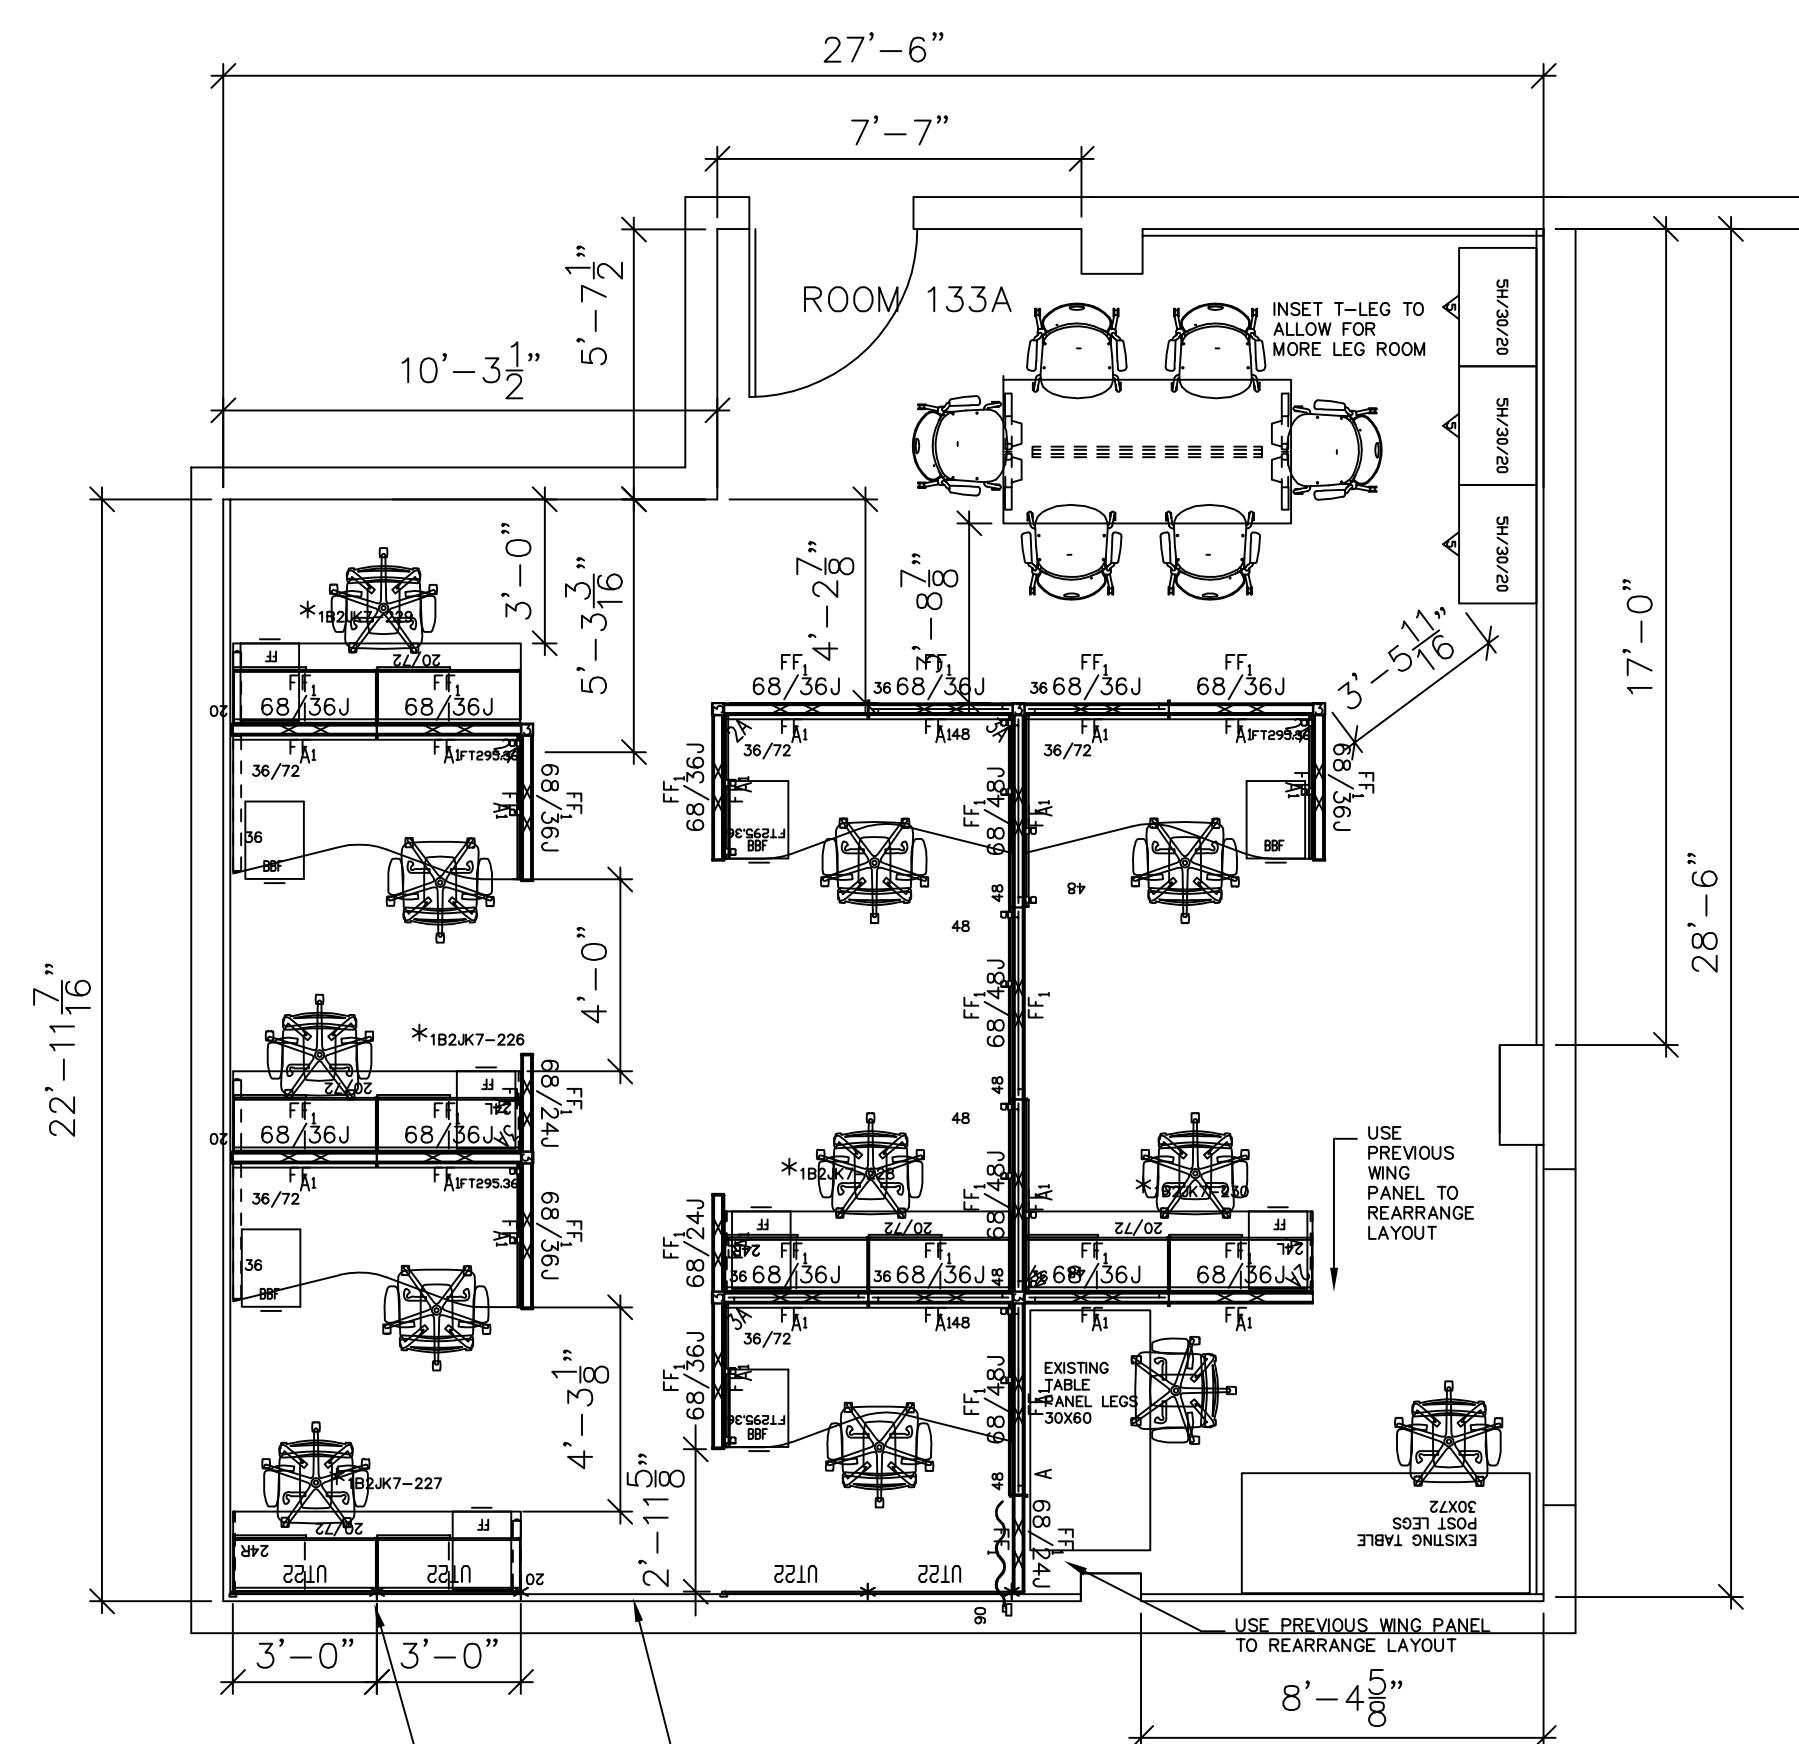

1 RECONFIGURE - OPT 1  
SCALE : 1/4"=1'-0"

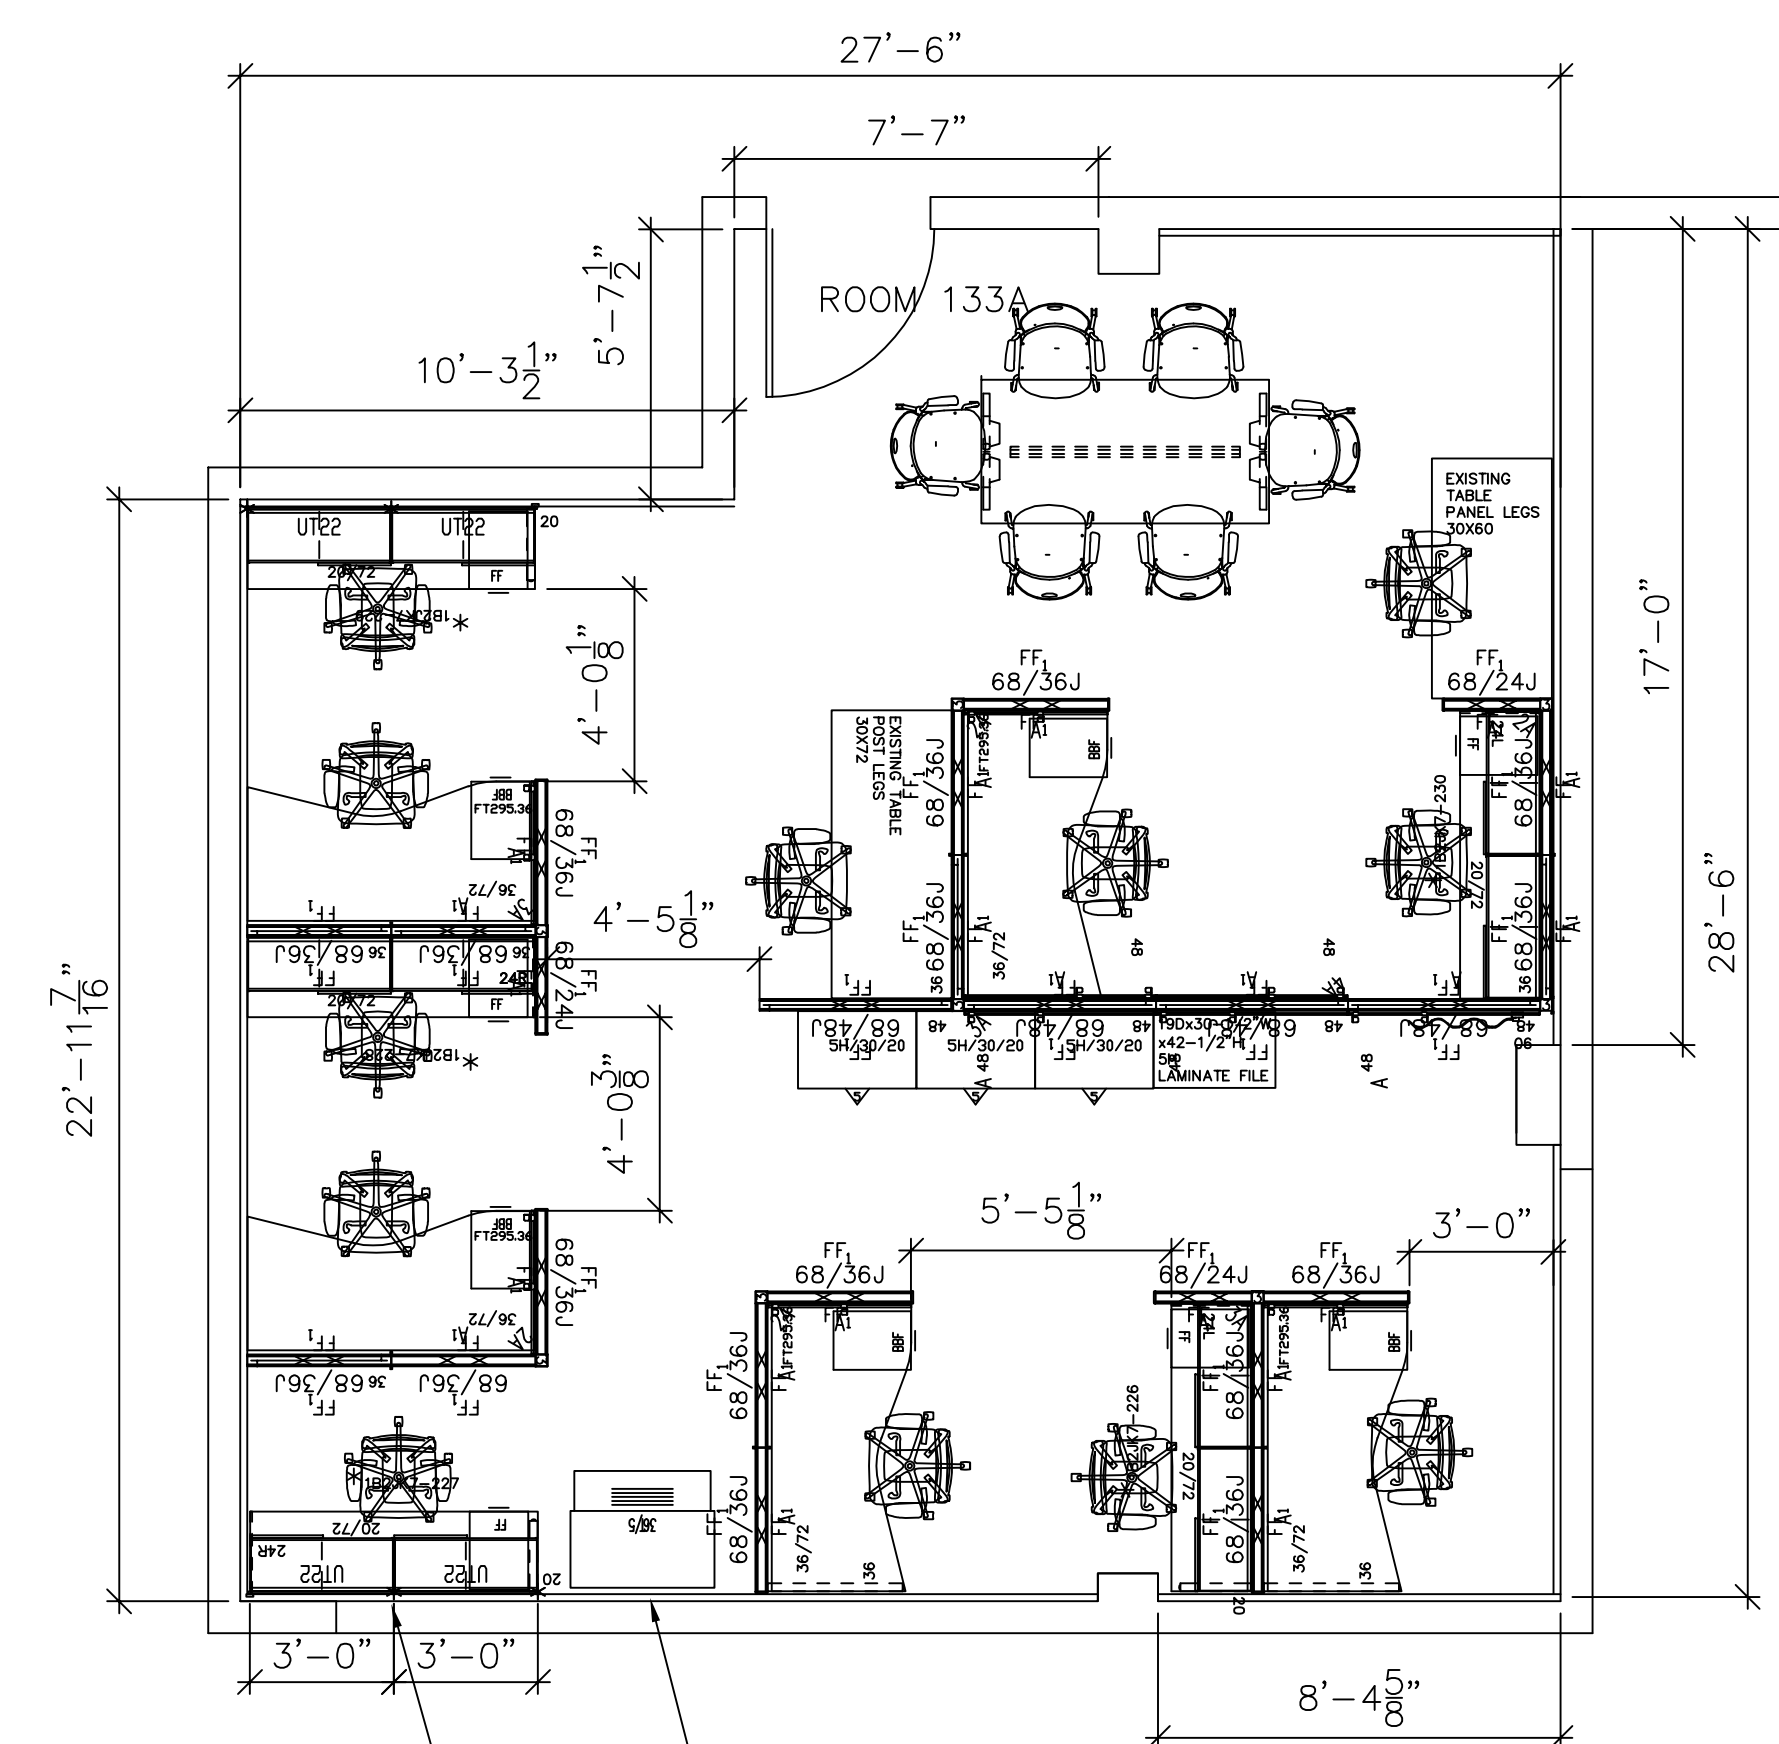

2 RECONFIGURE - OPT 2  
SCALE : 1/4"=1'-0"